

079/88

SL to 70m  
LS  
to gravel.

Newbold Manor Farm  
Barton - under - Needwood.


~~UNIT I~~ SL  
~~as Sand~~  
and gravel.

~~UNIT II~~ HCL

Revised.  
A/c (1988)

2.3ha

1988(b)  
application.

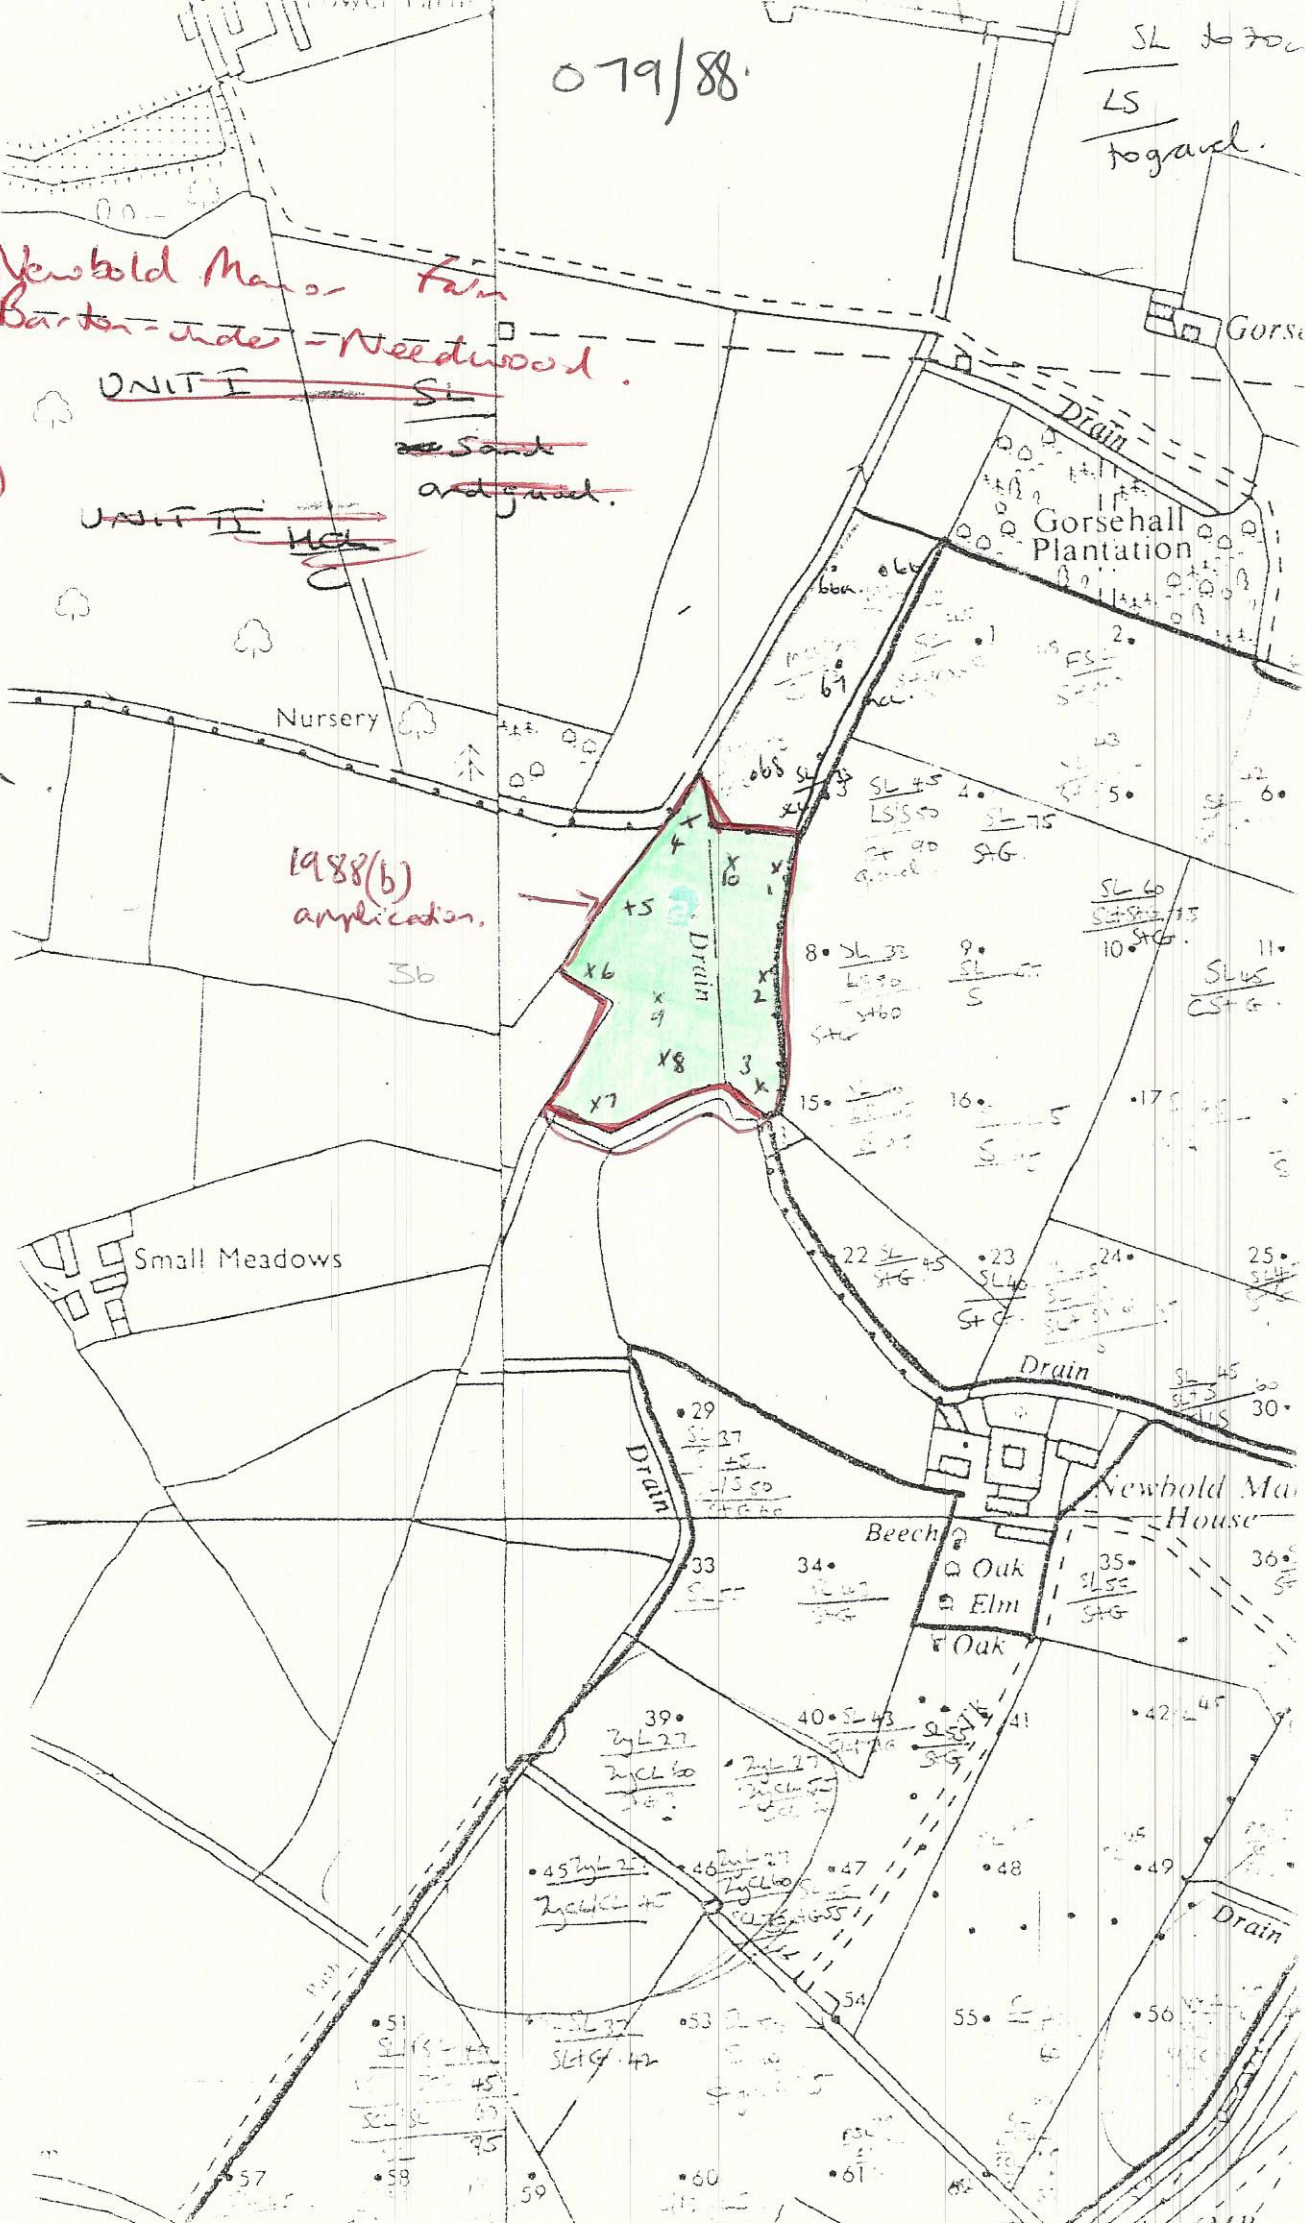


# SOIL RESOURCE MAP


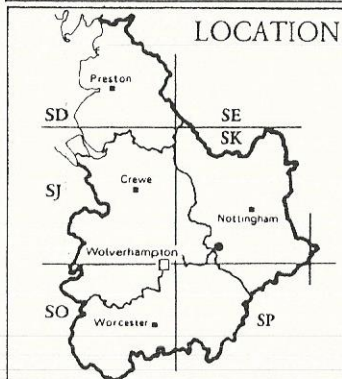
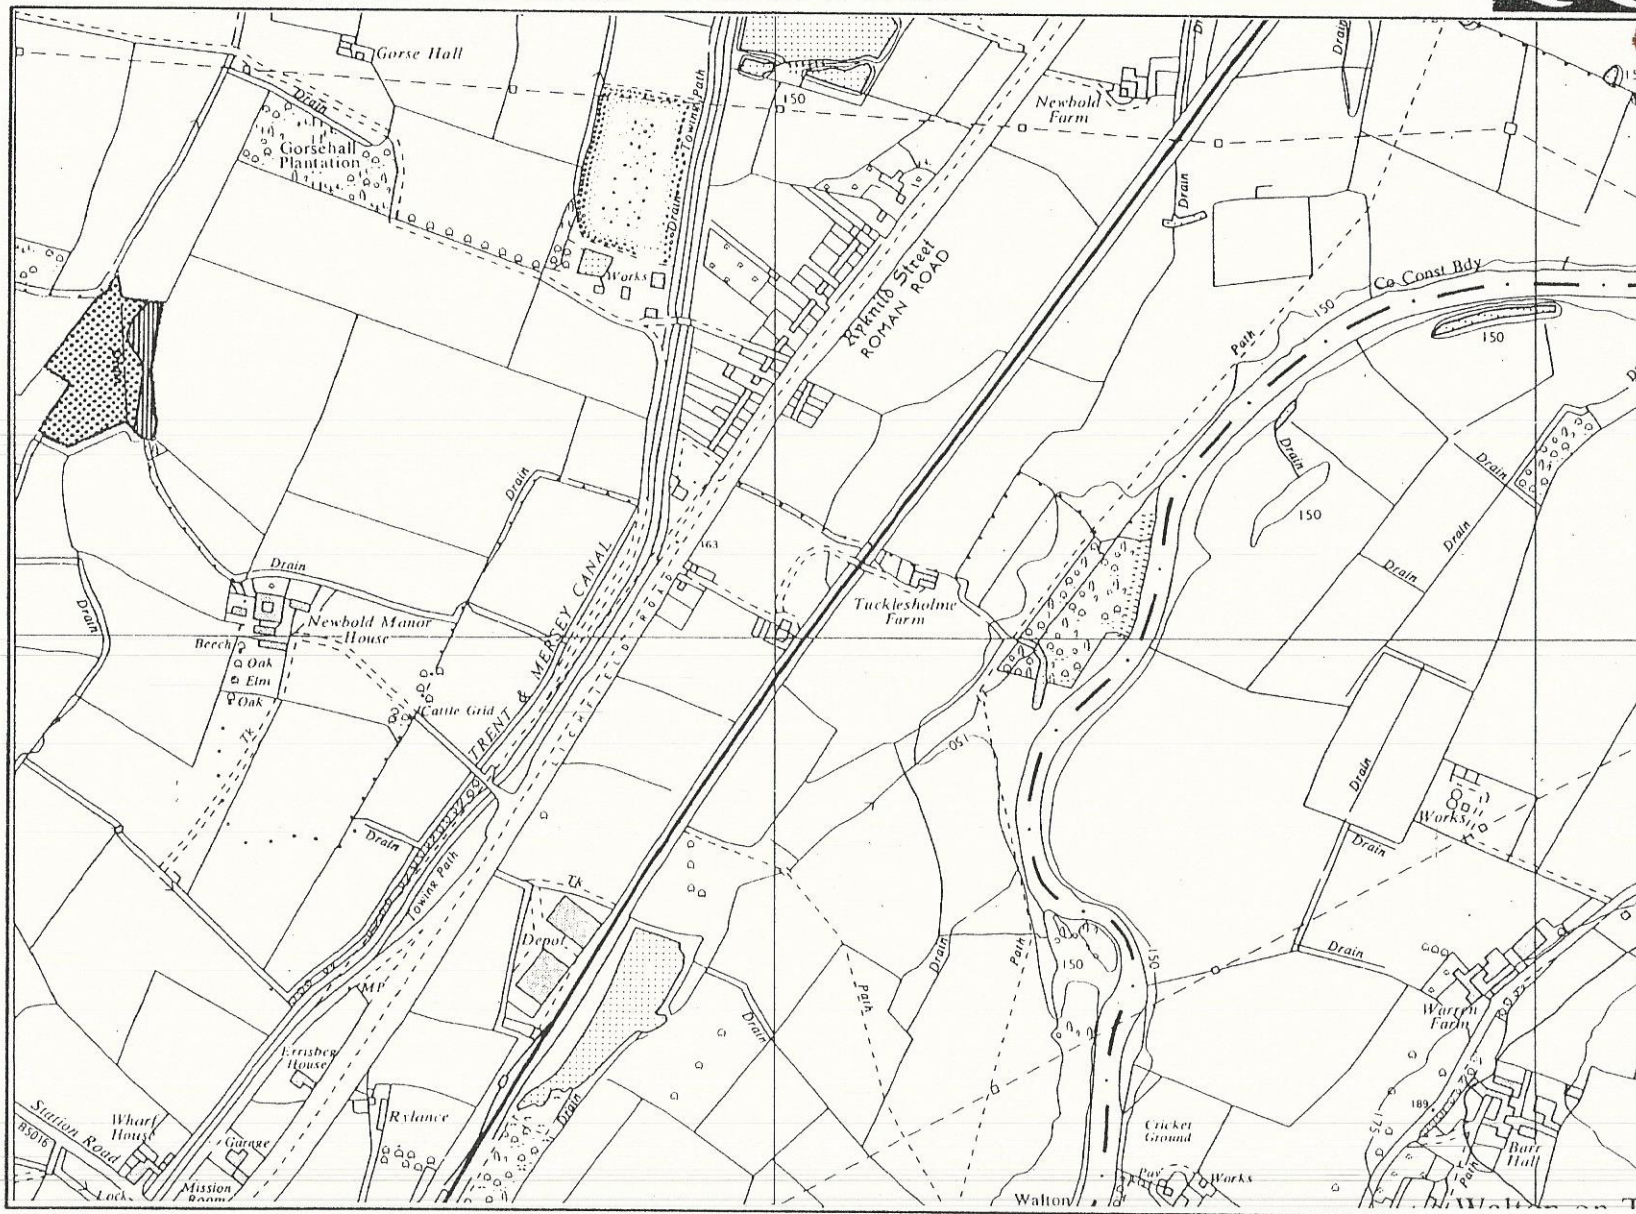
## NEWBOLD MANOR FARM BARTON – UNDER – NEEDWOOD



UNIT I  
C  
LS/S



UNIT II  
C

Source Maps SK 21 NW

Surveyed by Resource Planning Group  
Date, JAN 1989 Job No. 079/88  
Map produced by the Cartographic Unit,  
Farm and Countryside Service, Wolverhampton R.O.

SCALE 1:10000 0 200 400 metres